Date:

Wednesday, 7/5/2006 2:51:38 PM

User:

Kim Johnston

## **Process Sheet**

Customer

: CU-DAR001 Dart Helicopters Services

Job Number

: 27817B

**Estimate Number** 

: 10193

P.O. Number

Al4:

This issue : 7/5/2006

: NC

: NIA : 27816B

S.O. No. : NIA

: LARGE FAB ASSY

**Drawing Name** 

: 350/212/130 BASKET LID

: D2512 **Part Number** 

**Drawing Number** 

: D2512 REV D2

Project Number : N/A **Drawing Revision** 

: D2

Material

· NIA : 7/30/2006

Qty:

Each 1 Um:

Written By

Prsht Rev.

First Issue

**Previous Run** 

Checked & Approved By

Comment

Added D2012-117 for D130-701-041

COMMENT BELOW

RF

Est Rev:N 06.04.05 Added level21 EC

**Due Date** 

**Additional Product** 

Job Number:



Seq. #:

Machine Or Operation:

Description:

1.0 M304TS0750W065

304 SQ Tube.75x.75x.065W

Comment: Qty.: 45.7594 f(s)/Unit Total:

Pick:

45.7594 f(s)

3/4"x3/4" 304/316 SS tube .063" wall

M101309 -- 375,64" CP1 06.07.10

2.0

Comment: Qty.:

1.0000 Each(s)/Unit Total:

1.0000 Each(s)

Pick:

**Qty Part Number** 1 D3166-3

Description Basket Hoop

CPC 06.07.10

3.0 D2506



Comment: Qty.:

1.0000 Each(s)/Unit

2.0000 Each(s)/Unit

Total:

1.0000 Each(s)

Pick:

**Qty Part Number** 

Description

B26631-2

1 D2506

Label Plate

CPL 06.07.10

4.0

D23271

Spacer Bushing

Comment: Qty.:

Total:

2.0000 Each(s)

Pick:

**Qty Part Number** 

2 D2327-1

Description

Bushing

epl 06.p7.10

∢Aerospa	ce Ltd
----------	--------

W/O:		WORK ORDER CHANGES								
DATE	STEP	PROCEDURE CHANGE		PROCEDURE CHANGE By		By Date		Approval Mfg / Design Mgr	Approval QC Inspector	
							,			
•							-			
			,							
<del></del>								<u> </u>		

WORK ORDER NON-CONFORMANCE (NCR)							
Description of NC	Corrective Action Section B		Varification	A	A ====================================		
Section A	Initial Design Mgr	Action Description  Design Mgr	Sign & Date	Section C	Design Mgr	Approval QC inspector	
4.							
STEP	Section A	Section A Initial Design Mgr	Section A Initial Action Description Design Mgr Design Mgr	STEP Section A Initial Design Mgr Action Description Design Mgr Date	STEP Section A Initial Design Mgr Action Description Sign & Date Section C	STEP Section A Initial Design Mgr Action Description Design Mgr Section C Approval Design Mgr Design Mgr Design Mgr Section C Design Mgr	

Part No:	PAR #:	Fault Category:	NCR:	Yes	No	DQA:	Date:
NOTE: Date & initial all entries				QA: I	N/C C	losed:	Date:

Wednesday, 7/5/2006 2:51:38 PM Date: User: Kim Johnston **Process Sheet** Drawing Name: 350/212/130 BASKET LID Customer: CU-DAR001 Dart Helicopters Services Job Number: 27817B Part Number: D2512 Job Number: Seq. #: **Machine Or Operation:** Description: D22321 Hinge 5.0 Comment: Qtv.: 2.0000 Each(s)/Unit Total: 2.0000 Each(s) Pick: **Qty Part Number** Description Batch 2 D2232-1 Hinge plate CPL 06-07-10 6.0 D2581 Mounting Bracket Comment: Qty.: 2.0000 Each(s)/Unit Total: 2.0000 Each(s) Pick: **Qty Part Number** Description CPL 06.07.10 2 D2581 Mounting Bracket 7.0 M304EX07516F Comment: Qty.: 18.0000 sf(s)/Unit Total: 18.0000 sf(s) Pick: **Qty Part Number** Batch Description CPL 06.07.14 M101358 18 sf M304EX0.75-16F Expanded Metal \_ 8.0 LARGE FAB 1 LARGE FABRICATION RESOURCE 1 Comment: LARGE FABRICATION RESOURCE 1 1-Cut 3/4" x 3/4" square tubing as per Dwg D2512 CPC 06.07.18 2-Cut (4) D2236 From D3166-3

3-Drill holes in D2512-1 as per Dwg D2512 using Drill Jig DT8305

5-Weld as per Dwg D2512 using Welding Table and corner Jig Deburr as required

9.0 QC9/

DDIMENSIONAL & WELDING INSPECTION



Comment: DDIMENSIONAL & WELDING INSPECTION



DD 06-07-19 (

## Dart Aerospace Ltd

W/O:		WORK ORDER CHANGES	ORDER CHANGES				
DATE	STEP	PROCEDURE CHANGE	Ву	Date	Qty	Approval Mfg / Design Mgr	Approval QC Inspector
	;						
			ž				

NCR:		WORK ORDER NON-CONFORMANCE (NCR)								
		Description of NC		Corrective Action Section B		Verification	Annroyal	Annroval		
DATE	STEP	Section A	Initial Design Mgr	Action Description  Design Mgr	Sign & Date	Section C	Approval Design Mgr	Approval QC Inspector		
	,									
					•					
			· · · · · · · · · · · · · · · · · · ·	<u> </u>						
	-					,				

Part No:	PAR #:	Fault Category:	NCR:	Yes No DQA:	Date: <u>06/08/14</u>
NOTE: Date & initial all entries				QA: N/C Closed:	Date:

Date: Wednesday, 7/5/2006 2:51:38 PM User: Kim Johnston **Process Sheet** Drawing Name: 350/212/130 BASKET LID Customer: CU-DAR001 Dart Helicopters Services Job Number: 27817B Part Number: D2512 Job Number: Seq. #: Description: **Machine Or Operation:** POWDER COATING POWDER COATING 10.0 0 50 **Comment: POWDER COATING** Powder Coat White Gloss (Ref: 4.3.5.1) as per QSI 005 4.3 HAND FINISHING RESOURCE #1 11.0 M101667 (wins Walk Comment: HAND F Batch: M 1812 42 (spay paint Wing Walk and Spray Paint black as per Dwg D2512 and QSI 005 4.4 INSPECT POWDER COAT/CHEMICAL CONVERSION 12.0 QC3 Comment: INSPECT POWDER COAT/CHEMICAL CONVERSION PACKAGING RESOURCE #1 13.0 PACKAGING Comment: PACKAGING RESOURCE #1 Identify and Stock Location: 14.0 DOCUMENT CONTROL Comment: DOCUMENT CONTROL Inspection Level 21 CZ008114 Job Completion

## Dart Aerospace Ltd

W/O:		WORK ORDER CHA	WORK ORDER CHANGES					
DATE	STEP	PROCEDURE CHANGE B	E CHANGE By			Qty	Approval Mfg / Design Mgr	Approval QC Inspector
<u> </u>								

NCR: WORK ORDER NON-CONFORMANCE (NCR)								
		Description of NC		Corrective Action Section B		Verification		
DATE	STEP	Section A			Section C	Approval Design Mgr	Approval QC Inspector	
	,							
			,					
	-			, , , , , , , , , , , , , , , , , , ,				
		,						

Part No:	PAR #:	Fault Category:	NCR:	Yes	No	DQA:	Date:
NOTE: Date & initial all entries				QA: N	I/C CI	osed:	Date:






DESIGN BW	DRAWN BY	DART AEROSPACE LTD HAWKESBURY, ONTARIO, CANADA
CHECKED /	APPROVED	DRAWING NO. REV. D
A	d	D2512 SHEET 1 OF 4
DATE		TITLE SCALE
01.04.19		BASKET LID ASSEMBLY (350/212) NTS
Α	95.11.21	NEW ISSUE
	00.05.04	ADDED LATCH CHANNEL & LAREL PLATE

DATE		TITLE SCALE
1	04.19	BASKET LID ASSEMBLY (350/212) NTS
Α	95.11.21	NEW ISSUE
В	96.05.24	ADDED LATCH CHANNEL & LABEL PLATE
С	99.07.06	REMOVE DOUBLE SKIN SECTION, ADDED MEMBERS, INCORP. DEO 9074
D	01.04.19	CHANGE HINGE
DI	d (1) 03.01.20	ADD 02012-117 FOR 0130-701-041
02	Jeff 04.09.20	TACK WELD ANT-SKID AREA
a. S. villetinishing		LID ACCEMBLY

PARTS LIST FOR D2512 BASKET LID ASSEMBLY

PART NO	QUANTITY	LENGTH	LENGTH	DESCRIPTION
		Α	В	
D2512-1	2		25.50	RIB
D2512-3	2		95.30	RIB
D2512-5		30.84		RIB
D2512-7		30.63		RIB
D2232-1	2	N/A	N/A	HINGE PLATE
D2236	4	N/A	N/A	RIB
D2327-1	2	N/A	N/A	BUSHING
D2506	1	N/A	N/A	LABEL PLATE
D2581	2	N/A	N/A	MOUNTING BRKT

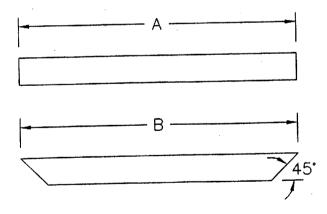

SHOP COPY RETURN TO ENGINEERING UNCONTROLLED COP SUBJECT TO AMENDMEN WITHOUT NOTICE WORK ORDER NO. 27817

D2512-1/-3/-5/-7


CUT LENGTH/SHAPE PER DIAGRAM AND PARTS LIST


MATERIAL: AISI 304/316 SS, 3/4 X 3/4 X 0.060 WALL SQUARE TUBING TOLERANCES ARE PER DART QSI 018 UNLESS OTHERWISE NOTED

ALL DIMENSIONS ARE IN INCHES

Copyright © 1995 by DART AEROSPACE LTD

THIS DOCUMENT IS PRIVATE AND CONFIDENTIAL AND IS SUPPLIED ON THE EXPRESS CONDITION THAT IT IS NOT TO BE USED FOR ANY PURPOSE OR COPIED OR COMMUNICATED TO ANY OTHER PERSON WITHOUT WRITTEN PERMISSION FROM DART AEROSPACE LTD.

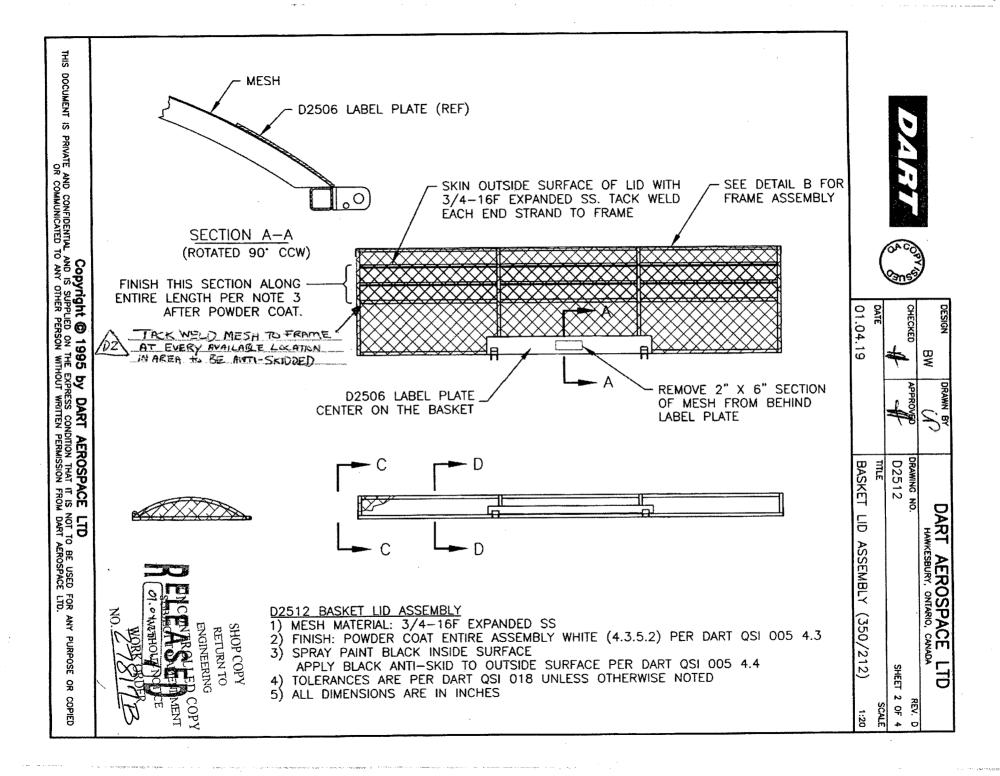


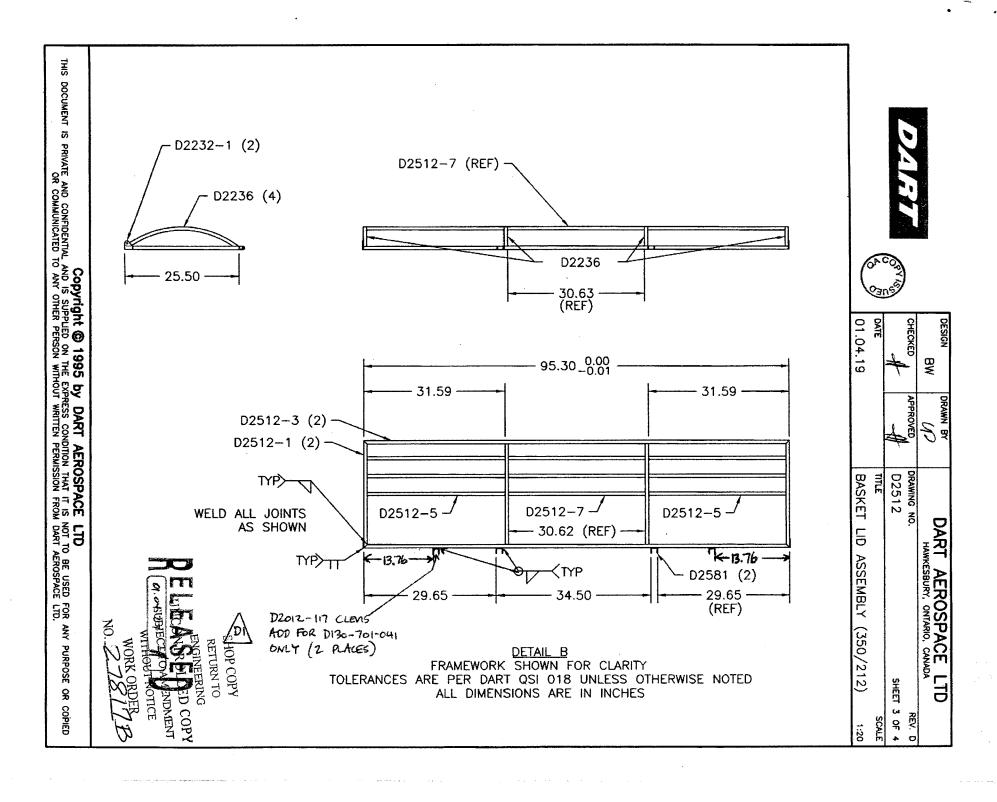

Nation	<b>横</b> ,一个一个一个一个一个一个一个一个一个一个一个一个一个一个一个一个一个一个一个	phillip.
		1 2 2 100 11
		i jujil"
i i i i i i i i i i i i i i i i i i i		
		<del>बार्के हें के किए किए किए किए किए किए किए किए किए किए</del>
,		
•		
7		




	DESIGN BW	DRAWN BY	DART AEROSPACE LTD HAWKESBURY, ONTARIO, CANADA				
	CHECKED	APPROVED	DRAWING NO. D2512 SHEET	REV. 4 OF	_		
	DATE		TITLE	SCA	LE		
_	01.04.19		BASKET LID ASSEMBLY (350/212)	1	8:1		

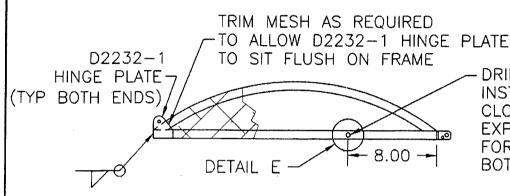


DRILL 3/8 HOLE AND INSTALL D2327-1 USING CLOSEST SPACE IN EXPANDED METAL FOR HOLE LOCATION BOTH ENDS

## SECTION C-C SIMILIAR BOTH END RIBS

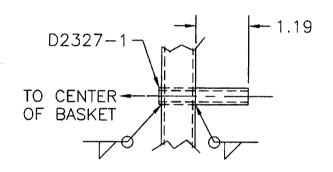

DETAIL E

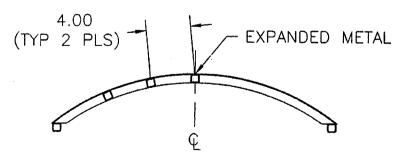

SECTION D-D SAME BOTH CENTER RIBS

SHOP COPY

Copyright © 1995 by DART AEROSPACE LTD

THIS DOCUMENT IS PRIVATE AND CONFIDENTIAL AND IS SUPPLIED ON THE EXPRESS CONDITION THAT IT IS NOT TO BE USED FOR ANY PURPOSE OR COPIED OR COMMUNICATED TO ANY OTHER PERSON WITHOUT WRITTEN PERMISSION FROM DART AEROSPACE LTD.